



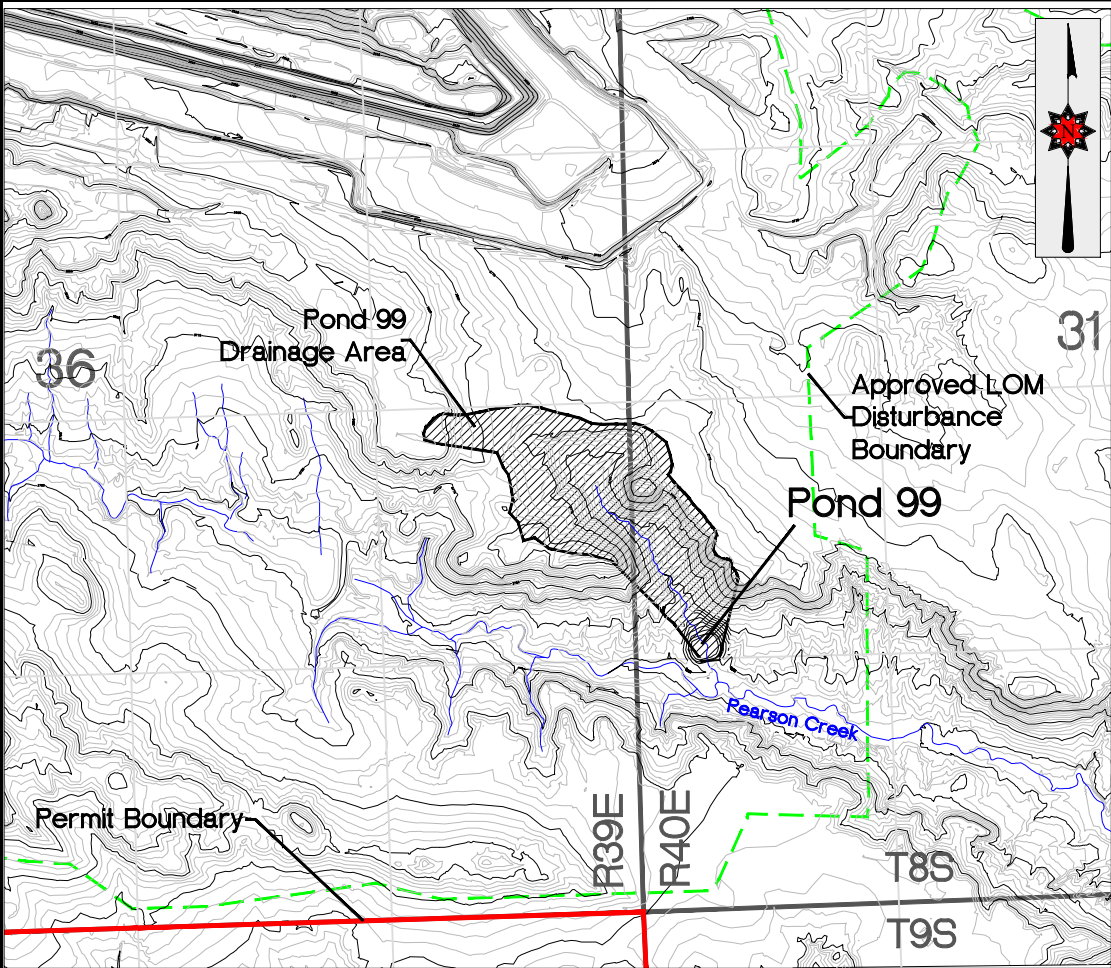

LOCATION MAP


SCALE: 1" = 1,000', C.I. = 5'

POND IS LOCATED PRIMARILY IN NWSW OF SECTION 31, T8S, R40E.

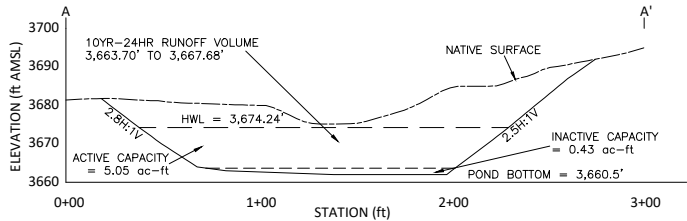


POND PROFILE A-A'

SCALE: H: 1" = 100', V: 1" = 50'

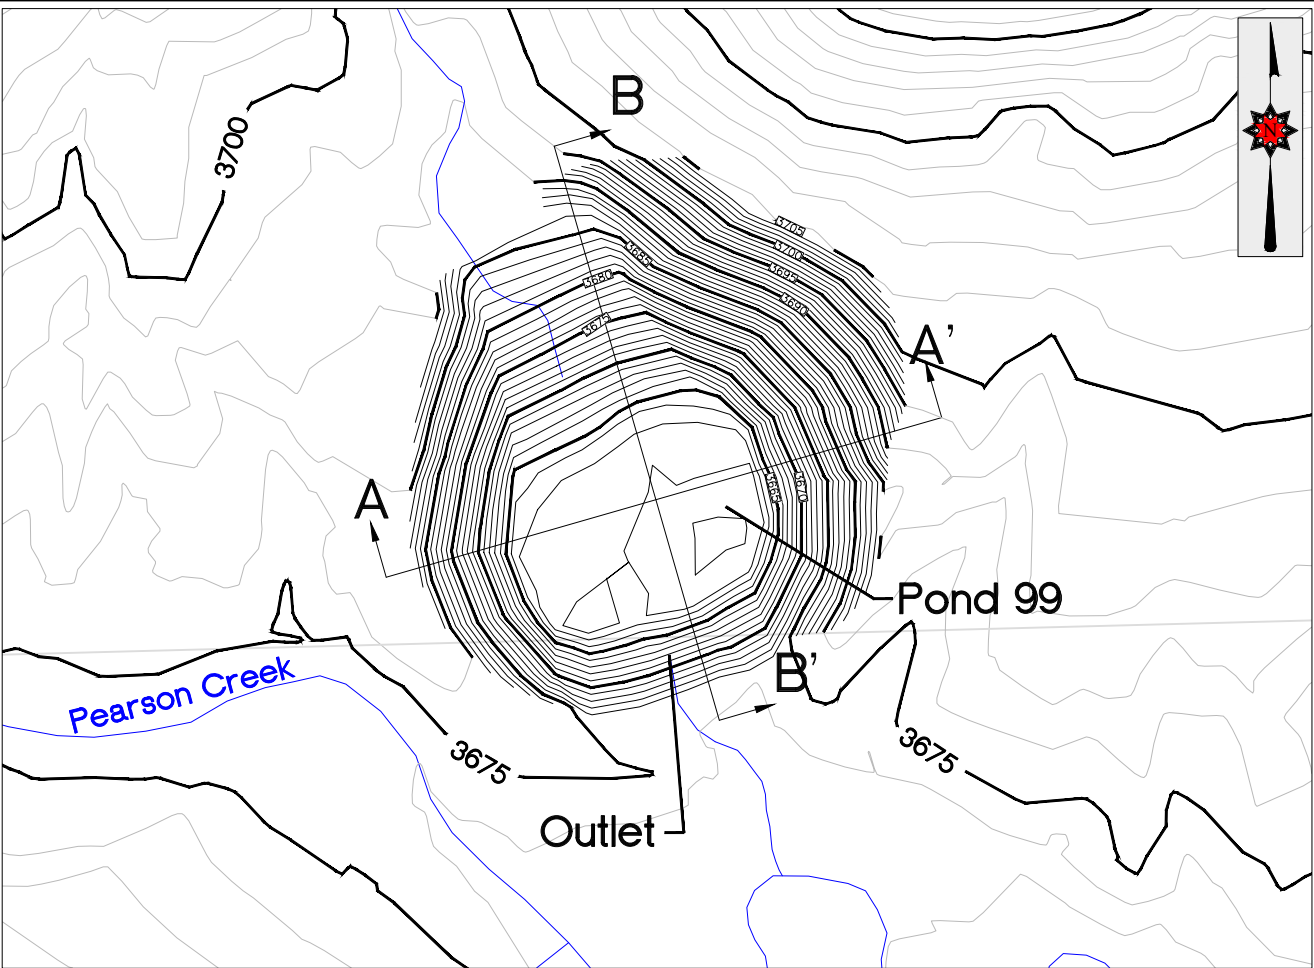

PLAN MAP

SCALE: 1" = 100', POND C.I. = 1', OUTER C.I. = 5'

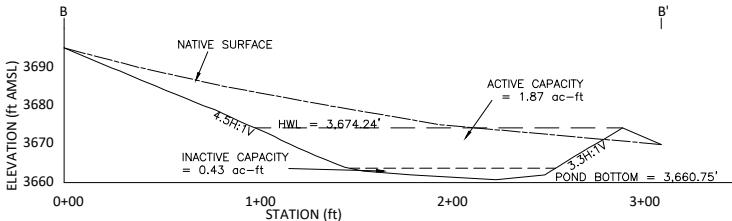

POND PROFILE B-B'

SCALE: H: 1" = 100', V: 1" = 50'

| AREA-ELEVATION-CAPACITY TABLE |              |                                  |                                 |                                               |
|-------------------------------|--------------|----------------------------------|---------------------------------|-----------------------------------------------|
| ELEVATION (FT AMSL)           | AREA (ACRES) | INCREMENTAL CAPACITY (ACRE-FEET) | CUMULATIVE CAPACITY (ACRE-FEET) | USE                                           |
| 3,660.75                      | 0.00         | 0.00                             | 0.00                            | INACTIVE CAPACITY VOLUME = 0.43 AC-FT.        |
| 3,661.00                      | 0.01         | 0.25                             | 0.00                            |                                               |
| 3,663.00                      | 0.24         | 0.18                             | 0.26                            | sediment storage                              |
| 3,663.70                      | 0.27         | 0.39                             | 0.43                            |                                               |
| 3,665.00                      | 0.33         | 0.74                             | 0.83                            | ACTIVE CAPACITY VOLUME = 5.05 AC-FT.          |
| 3,667.00                      | 0.41         | 0.88                             | 1.56                            |                                               |
| 3,669.00                      | 0.48         | 1.03                             | 2.45                            | 10-YEAR / 24-HOUR RUNOFF VOLUME = 1.87 AC-FT. |
| 3,671.00                      | 0.55         | 1.19                             | 3.48                            |                                               |
| 3,673.00                      | 0.63         | 0.65                             | 4.66                            |                                               |
| 3,674.00                      | 0.67         | 0.16                             | 5.32                            |                                               |
| 3,674.24                      | 0.68         |                                  | 5.48                            |                                               |

POND 99 DRAINAGE AREA DATA

TOTAL DRAINAGE AREA = 21.3 acres  
LONGEST WATERCOURSE = 2,283 ft  
AVERAGE LAND SLOPE = 24.78%  
CURVE NUMBER = 87 (Disturbed Mine Land)  
SOILS = Hydrologic Soils Group C  
TIME OF CONCENTRATION = 0.162 Hours

RUNOFF ESTIMATE TO POND 99


RAINFALL DISTRIBUTION = SCS TYPE II  
PRECIPITATION (10YR-24HR) = 2.19 in  
PEAK Q (10YR-24HR) = 29.85 cfs  
VOLUME (10YR-24HR) = 1.87 ac-ft  
DESIGN METHOD = SCS RUNOFF CURVE NUMBER METHOD AND SCS GRAPHICAL PEAK DISCHARGE METHOD (NRCS TR-55 METHOD)

POND 99 DESIGN CAPACITY


SEDIMENT CAPACITY (0.02 ac-ft per acre) = 0.43 ac-ft  
10YR-24HR RUNOFF VOLUME = 1.87 ac-ft  
TOTAL DESIGN CAPACITY = 2.30 ac-ft

CERTIFICATE OF ENGINEER

I, Owen Lindblom, hereby certify that this map and drawing was prepared by myself or under my direct supervision and that they correctly represent the facilities and conditions described in the accompanying application.

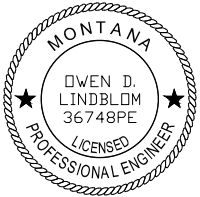

OWEN D. LINDBLOM, P.E. No. 36748PE

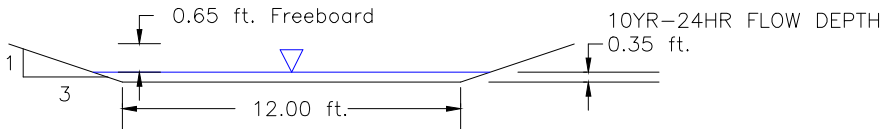

Trapezoidal Channel  
Equal Side Slopes

Channel Lining: NAG Erosion Control Blanket P300 or Equivalent

INLET CHANNEL AND EROSION PROTECTION

SCALE: AS SHOWN

CHANNEL TYPE = TRAPEZOIDAL, EQUAL SIDE SLOPES  
BOTTOM WIDTH = 12 ft  
SIDE SLOPES = 3H:1V  
MAXIMUM SLOPE = 33% (POND FACE SLOPE)  
10YR-24HR PEAK FLOW = 28.85 cfs  
CHANNEL LINING = N.A.G. P300 EROSION CONTROL BLANKET (PERMANENT) WITH VEGETATION

INLET CHANNEL HYDRAULICS

RETARDANCE CLASS = C  
VEGETATION TYPE = BUNCH TYPE  
VEGETATION DENSITY = FAIR (50-75%)  
SOIL TYPE = SILT LOAM  
VELOCITY = 6.61 ft/s  
NORMAL DEPTH = 0.35 ft  
MANNING'S N = 0.06  
PERMISSIBLE SHEAR STRESS = 8 lbs/ft<sup>2</sup>  
CALCULATED SHEAR STRESS = 7.13 lbs/ft<sup>2</sup>



|                                                                                                                    |          |                                                                                    |                  |     |          |       |             |                                  |    |   |
|--------------------------------------------------------------------------------------------------------------------|----------|------------------------------------------------------------------------------------|------------------|-----|----------|-------|-------------|----------------------------------|----|---|
|  <b>CLOUD PEAK</b><br>ENERGY® |          | <b>SPRING CREEK MINE</b><br>P.O. BOX 67, DECKER, MT 59025<br>PHONE: (406) 757-2581 |                  |     |          |       |             |                                  |    |   |
| DATE                                                                                                               | REVISION | <b>Sediment Control<br/>Pond 99 Design</b><br><br><b>As-Built</b>                  |                  |     |          |       |             |                                  |    |   |
| BY                                                                                                                 |          |                                                                                    |                  |     |          |       |             |                                  |    |   |
| 6/08/20                                                                                                            |          |                                                                                    |                  |     |          |       |             |                                  |    |   |
| ODL                                                                                                                |          |                                                                                    |                  |     |          |       |             |                                  |    |   |
|                                                                                                                    |          |                                                                                    |                  |     |          |       |             |                                  |    |   |
|                                                                                                                    |          |                                                                                    |                  |     |          |       |             |                                  |    |   |
| DESIGN                                                                                                             |          | EMD                                                                                | DRAWN            | EMD | DATE     | 11/17 | SHEET       | 1                                | OF | 1 |
| SCALE                                                                                                              | As Shown |                                                                                    | CONTOUR INTERVAL |     | As Shown |       | FILE NUMBER | Appch_Pond_99_M0262_20200526.dwg |    |   |