
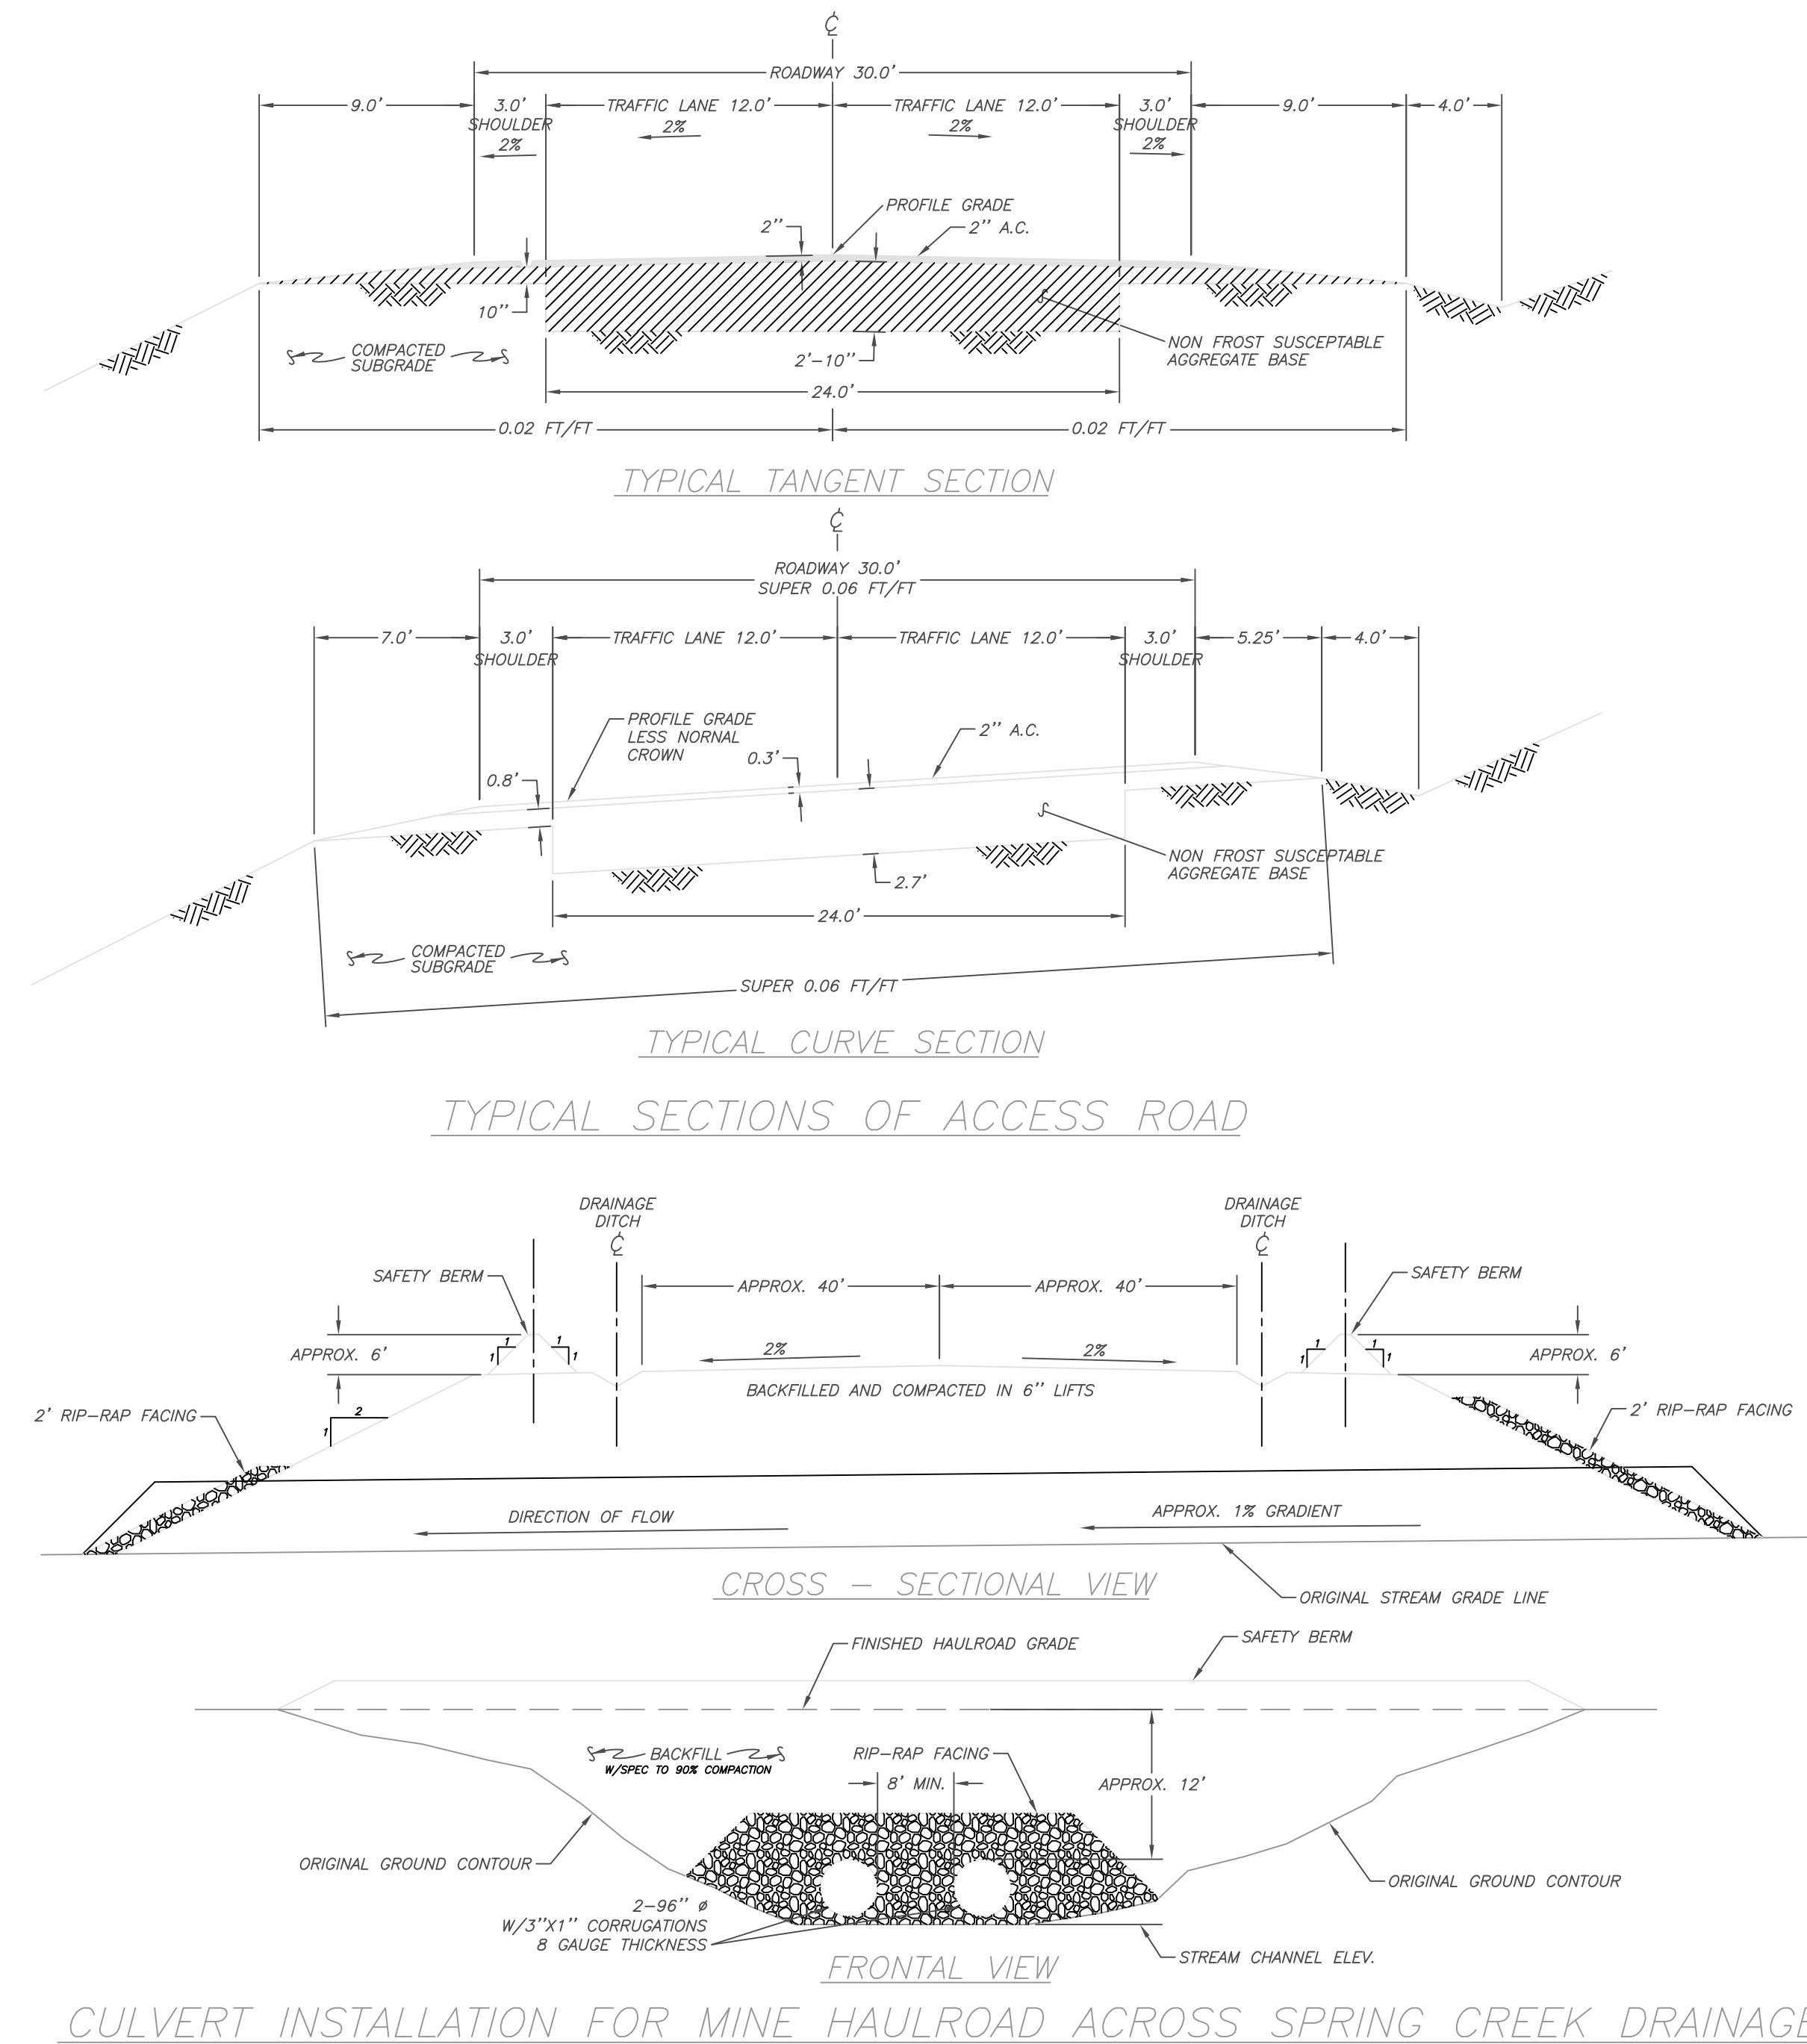
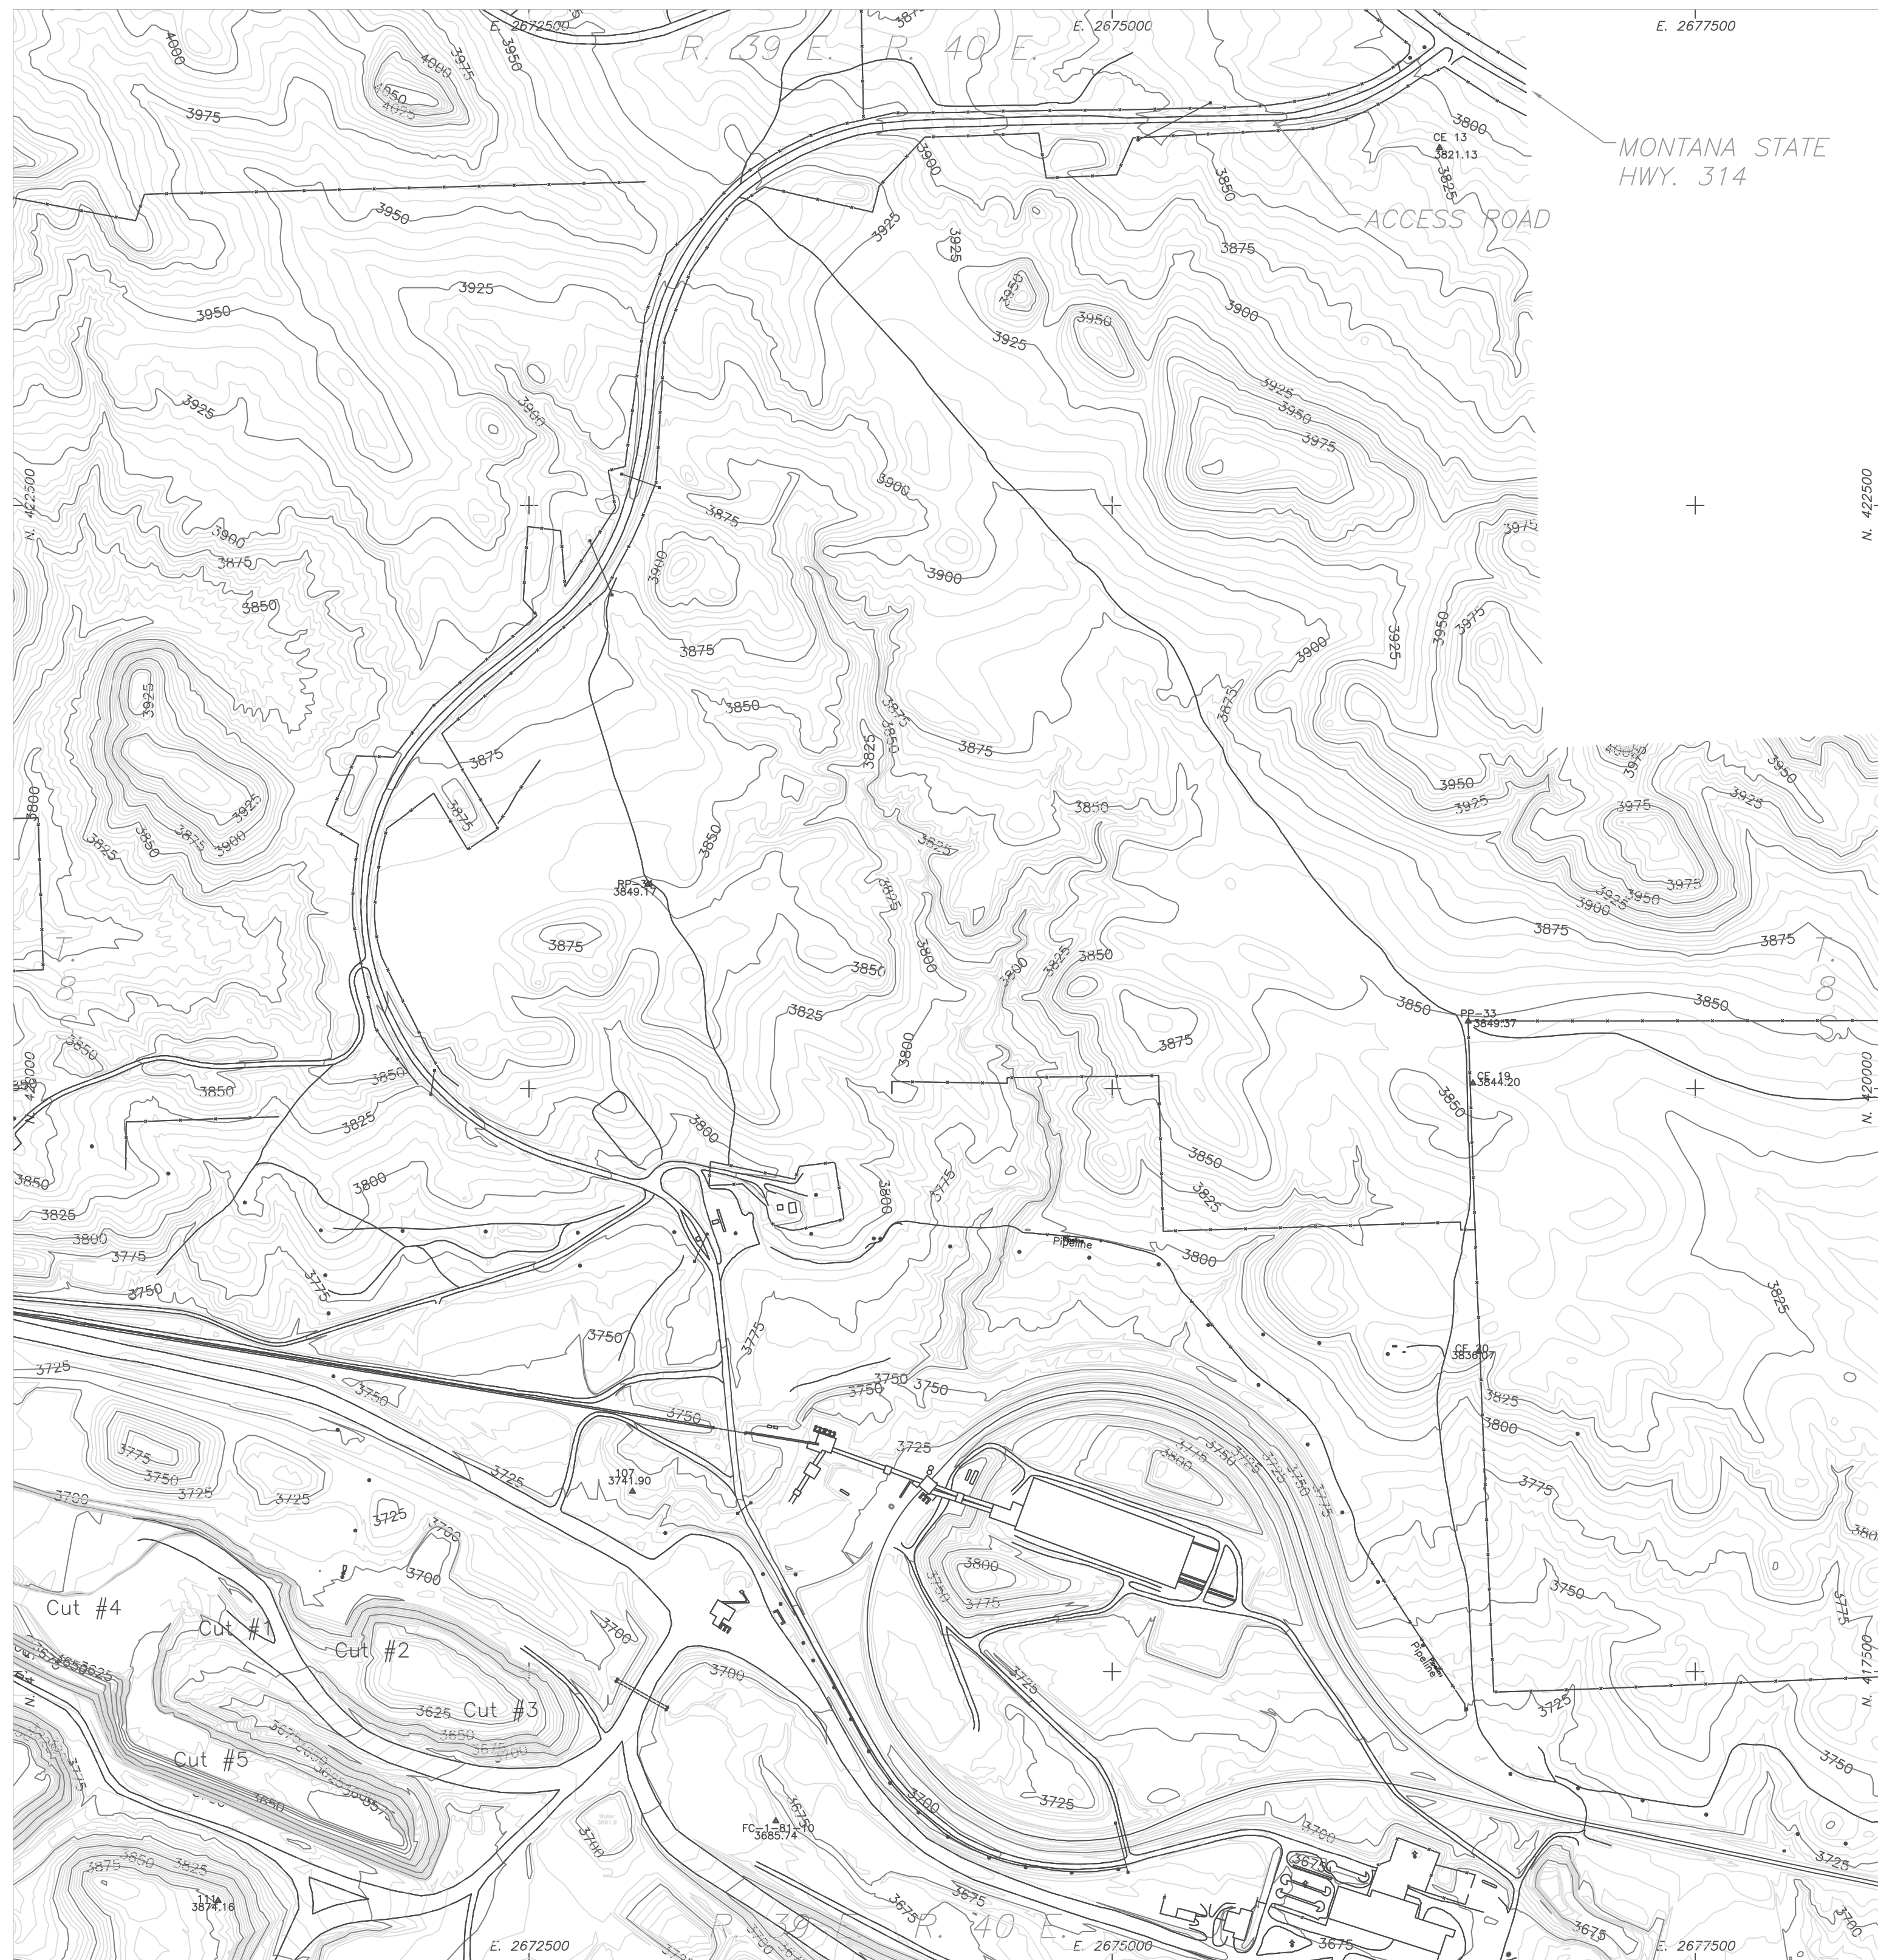


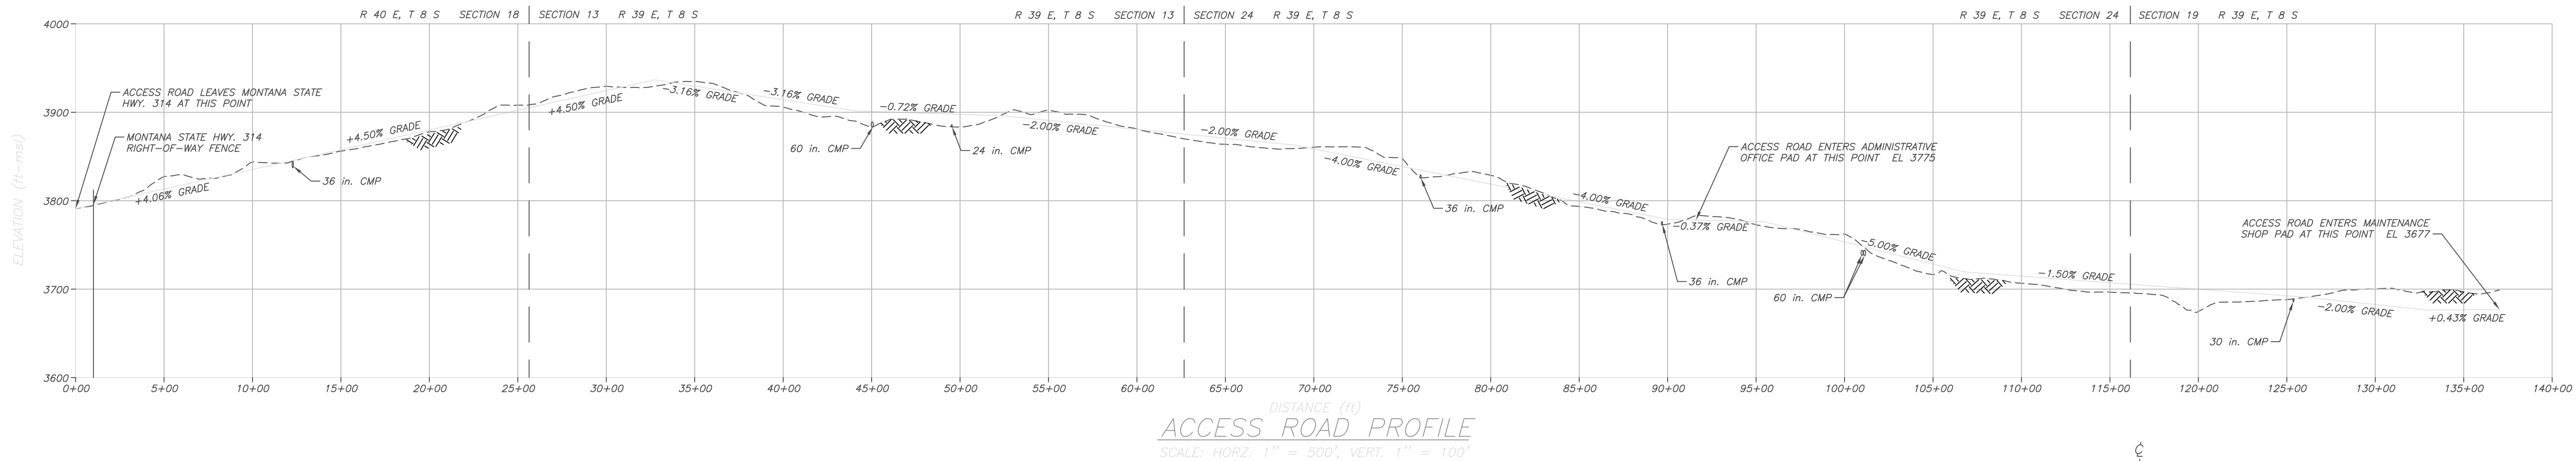

CERTIFICATE OF ENGINEER

I, Eric M. Detmer, hereby certify that this map was completed by myself or under my direct supervision, and is correct and shows, to the best of my belief, that the access road on the as-built drawing was constructed in accordance with the plan approved pursuant to APRM 17.24(2).

NOTARY PUBLIC

SUBSCRIBED AND SWORN BEFORE ME THIS

DAY OF

NOTARY PUBLIC

MY COMMISSION EXPIRES

CLOUD PEAK ENERGY		SPRING CREEK MINE	
P.O. BOX 67, DECKER, MT 59025		PHONE: (406) 757-2581	
DATE		REVISION	
BY		4/11	
SCC		APPLICATION 183	
DESIGN		SCC	
DRAWN		SCC	
DATE		04/11	
SHEET		1 OF 1	
SCALE AS SHOWN		CONTOUR INTERVAL 5'	
FILE NUMBER		Vol4_Plate_17_ACCESSROADSLT_20110426_APP183.dwg	